

OTTAWA COUNTY ENGINEERS OFFICE

REFERENCE NO. 33-7-16-B
NORTH QUARTER POST SEC. 33
ERIE TWP.
SHEET 1 OF 1.

ROUTE: S- #358 @ S- #2

TOWNSHIP: ERIE

SECTION: 33

T 7 NR 16 E.

PERSONNEL:
M. WITTMAN, P.S.
J. ALLEN


NORTHING:

EASTING:

DATUM:

DATE / WEATHER / TEMP:

JULY 21, 2014
SUNNY, N-NE
87° F

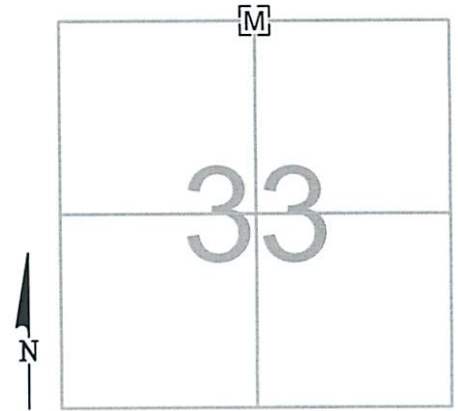

MONUMENT INFORMATION

MONUMENT TYPE: FD 1" SQ. IRON PIN IN MON BOX
ON SURFACE - BELOW: 0.06'
LEFT - CL PAV'T - RIGHT: 14.30'



MISC. INFORMATION

8-13-1999 - FD 5-1/2" X 4" TRIANGULAR STONE 2.34'
BELOW SURFACE BY ODOT CREWS WORKING IN
CONJUNCTION WITH OCE STAFF, R. NUHFER, P.S. &
M. BROUGH. PHOTO OF STONE NOT TAKEN. ODOT
SET IRON PIN IN MOMUMENT BOX OVER STONE
AUGUST OR SEPTEMBER 1999.

