

OTTAWA COUNTY ENGINEERS OFFICE

REFERENCE NO. 1-6-14-F
 EAST QUARTER POST SECTION 1
 HARRIS TWP.
SHEET 1 OF 1.

ROUTE: C-23 BENTON CARROLL RD.

TOWNSHIP: HARRIS

SECTION: 1


T 6 **NR** 14 **E.**

PERSONNEL:
 M. WITTMAN, P.S.
 J. ALLEN
 J. LAUBACHER

NORTHING:

EASTING:

DATUM:

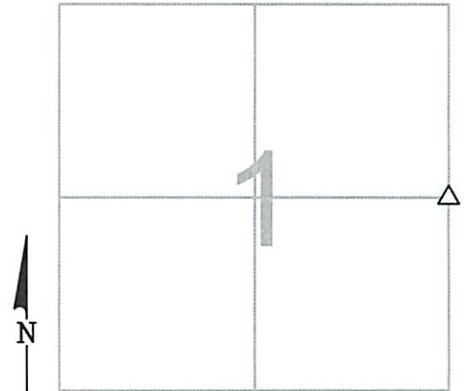

DATE / WEATHER / TEMP:
 AUGUST 5, 2011
 SUNNY NE
 81° F

MONUMENT INFORMATION

MONUMENT TYPE: FD 5 1/2" X 4 1/2" SANDSTONE W/ DH
 ON SURFACE - BELOW: 1.55'
LEFT - CL PAV'T - RIGHT: 1.5'



MISC. INFORMATION

FD RR SPK 0.05' BELOW SURFACE
 TIED W/ X-TIES & DUG FOR STONE
 RR SPK WAS 0.36' N & 0.50' E OF CENTER OF STONE
 USED THE DRILL HOLE

AUGUST 5, 2011

SET 1" SQUARE IRON PIN
 IN MONUMENT BOX OVER
 DH IN STONE

