

OTTAWA COUNTY ENGINEERS OFFICE

REFERENCE NO. 1-6-14-I
 SE CORNER POST SECTION 1
 HARRIS TWP.
 SHEET 1 OF 1.

ROUTE: C-23 BENTON CARROLL RD.

TOWNSHIP: HARRIS

SECTION: 1

T 6 NR 14 E.

PERSONNEL:
 M. WITTMAN, P.S.
 J. ALLEN
 J. LAUBACHER


NORTHING:

EASTING:

DATE / WEATHER / TEMP:

JULY 28, 2011
 SUNNY HUMID
 83° F

DATUM:

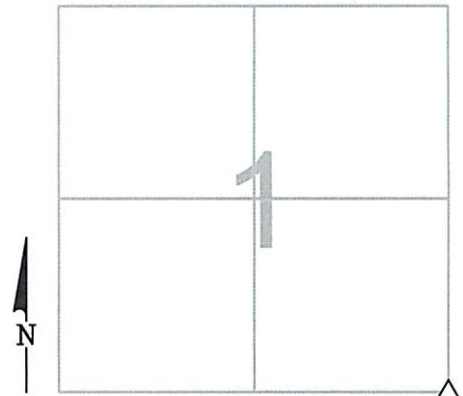

MONUMENT INFORMATION

MONUMENT TYPE: FD 11 1/2" X 9 3/4" HARDHEAD STONE W/ DH
 ON SURFACE - BELOW: 1.25'
LEFT - CL PAV'T - RIGHT: 3.95'



MISC. INFORMATION

FD 5/8" HARROW TOOTH 0.58' BELOW SURFACE
 TIED W/ X-TIES & DUG FOR STONE
 USED DRILL HOLE
 5/8" HARROW TOOTH WAS 0.04' N & 0.03' W OF
 DRILL HOLE IN STONE

JULY 28, 2011

SET 1" SQUARE IRON PIN
 IN MONUMENT BOX OVER
 STONE

