


OTTAWA COUNTY ENGINEERS OFFICE

REFERENCE NO. 12-6-14-C
 NE CORNER POST SECTION 12
 HARRIS TWP.
 SHEET 1 OF 1.

ROUTE: C-23 BENTON CARROLL RD.
 TOWNSHIP: HARRIS
 SECTION: 12
 T 6 NR 14 E.

PERSONNEL:
 M. WITTMAN, P.S.
 J. ALLEN
 J. LAUBACHER

NORTHING:
 EASTING:
 DATUM:

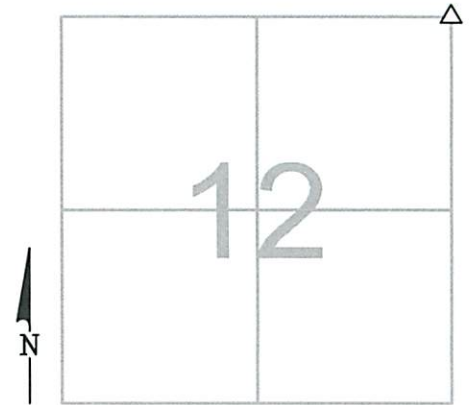

DATE / WEATHER / TEMP:
 JULY 28, 2011
 SUNNY HUMID
 83° F

MONUMENT INFORMATION

MONUMENT TYPE: FD 11 $\frac{1}{2}$ " X 9 $\frac{3}{4}$ " HARDHEAD STONE W/ DH
 ON SURFACE - BELOW: 1.25'
LEFT - CL PAV'T - RIGHT: 3.95'



MISC. INFORMATION

FD $\frac{5}{8}$ " HARROW TOOTH 0.58' BELOW SURFACE
 TIED W/ X-TIES & DUG FOR STONE
 USED DRILL HOLE
 $\frac{5}{8}$ " HARROW TOOTH WAS 0.04' N & 0.03' W OF
 DRILL HOLE IN STONE

JULY 28, 2011

SET 1" SQUARE IRON PIN
 IN MONUMENT BOX OVER
 STONE

