

OTTAWA COUNTY ENGINEERS OFFICE

REFERENCE NO. 13-6-13-D
WEST QUARTER POST SEC. 13
HARRIS TWP.
SHEET 1 OF 1.

ROUTE: T-214 OPFER-LENTZ RD.

TOWNSHIP: HARRIS

SECTION: 13

T 6 NR 13 E.


NORTHING:

EASTING:

DATUM:

PERSONNEL:
M. WITTMAN, P.S.
J. ALLEN
M. BROUGH

DATE / WEATHER / TEMP:
FEBRUARY 23, 2012
OVERCAST - S
40° F

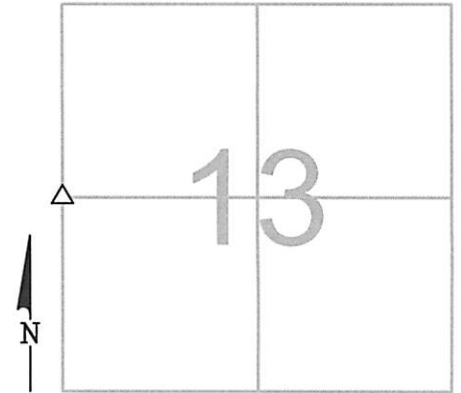

MONUMENT INFORMATION

MONUMENT TYPE: FD 6" X 8" X 12" LIMESTONE
ON SURFACE - BELOW: 1.32'
LEFT - CL PAV'T - RIGHT: 8.30'

BELL SHAPED STONE

SET DRILL HOLE IN HIGH POINT OF STONE



MISC. INFORMATION

FD PK NAIL 0.15' BELOW PAVEMENT SURFACE TIED
W/ X-TIES AND DUG FOR STONE
PK WAS 0.07' N AND 0.09' E FROM HIGH POINT
STONE IS AT EAST EDGE OF PAVEMENT

FEBRUARY 23, 2012

SET 1" SQUARE IRON PIN
IN MONUMENT BOX OVER
STONE

