

OTTAWA COUNTY ENGINEERS OFFICE

REFERENCE NO. 13-6-13-I
SE CORNER POST SEC. 13
HARRIS TWP.
SHEET 1 OF 1.

PERSONNEL:
M. WITTMAN, P.S.
J. ALLEN

DATE / WEATHER / TEMP:
MAY 11, 2015
SUNNY - SW
84° F

ROUTE: C-18 PORTAGE RIVER SO. RD.
@ STATE ROUTE #51

TOWNSHIP: HARRIS


SECTION: 13

T 6 NR 13 E.

NORTHING:

EASTING:

DATUM:

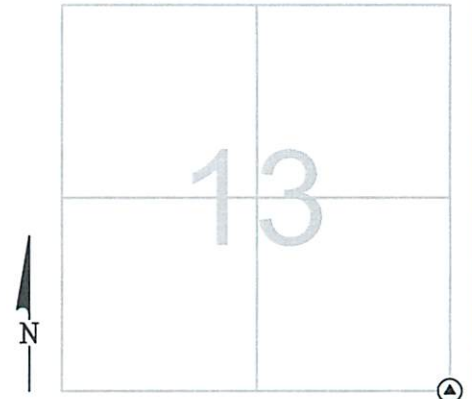

MONUMENT INFORMATION

MONUMENT TYPE: FD 2 3/4" Ø BRASS DISK IN CONC
ON SURFACE - BELOW:
LEFT - CL PAV'T - RIGHT:
BRASS ODOT R/W DISK IN 6" Ø CONCRETE



MISC. INFORMATION

IN GRASS YARD OF 209 RICE STREET, ELMORE

