

# OTTAWA COUNTY ENGINEERS OFFICE

REFERENCE NO. 13-6-14-H  
 SOUTH QUARTER POST SEC. 13  
 HARRIS TWP.  
 SHEET 1 OF 1.

ROUTE: C-6 ELMORE-EASTERN RD.

TOWNSHIP: HARRIS


SECTION: 13

T 6 NR 14 E.

NORTHING:

EASTING:

DATUM:

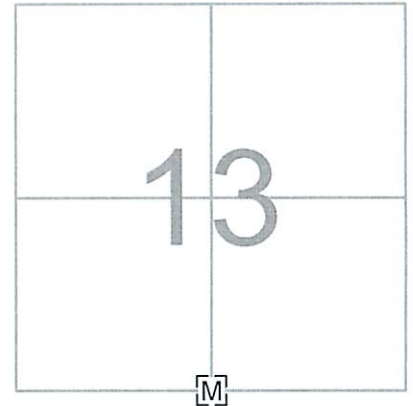

PERSONNEL:  
 M. WITTMAN, P.S.  
 J. ALLEN

DATE / WEATHER / TEMP:  
 JUNE 16, 2016  
 OVERCAST - W  
 79° F

### MONUMENT INFORMATION

MONUMENT TYPE: FD. 1-1/4" Ø IRON PIPE IN MON BOX  
 ON SURFACE - BELOW: 0.58'  
LEFT - CL PAV'T - RIGHT: 0.35'



### MISC. INFORMATION

JUNE 16, 2016

SET MONUMENT BOX OVER 1-1/4"  
 Ø IRON PIPE IN MONUMENT BOX

