

OTTAWA COUNTY ENGINEERS OFFICE

REFERENCE NO. 13-6-14-I
SE CORNER POST SECTION 13
HARRIS TWP.
SHEET 1 OF 1.

ROUTE: C-42 HARRIS-SALEM RD.
@ C-6 ELMORE EASTERN RD.

TOWNSHIP: HARRIS

SECTION: 13

T 6 NR 14 E.


NORTHING:

EASTING:

DATUM:

PERSONNEL:
M. WITTMAN, P.S.
J. ALLEN
K. SMITH
S. ULLRICH

DATE / WEATHER / TEMP:
JULY 31, 2007
SUNNY
76° F

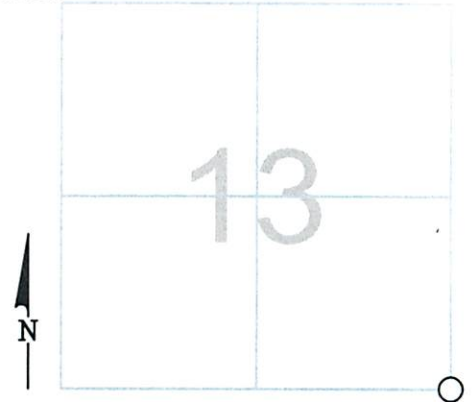

MONUMENT INFORMATION

MONUMENT TYPE: FD 1" Ø IRON PIN
ON SURFACE - BELOW: 0.71'
LEFT - CL PAV'T - RIGHT: 2.08'



MISC. INFORMATION

5-29-1958: FD. STONE, SET IRON PIN OVER
STONE PER OTTAWA COUNTY CORNERSTONE
REFERENCE

7-31-07 - ENHANCED FD DRILL HOLE IN PIN

JULY 31, 2007

SET MONUMENT BOX
OVER PIN

