

# OTTAWA COUNTY ENGINEERS OFFICE


REFERENCE NO. 14-6-13-B  
NORTH QUARTER POST SEC. 14  
HARRIS TWP.  
SHEET 1 OF 1.

ROUTE: T-50 WITTY RD.  
TOWNSHIP: HARRIS  
SECTION: 14  
T 6 NR 13 E.

PERSONNEL:  
M. WITTMAN, P.S.  
J. ALLEN  
B. BRADY  
M. HEINTZ

NORTHING:  
EASTING:  
DATUM:

DATE / WEATHER / TEMP:  
APRIL 30, 2024  
SUNNY W  
70° F

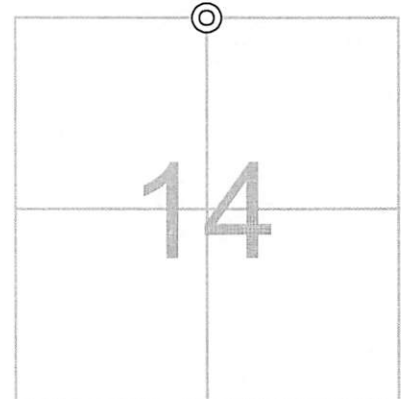

## MONUMENT INFORMATION

MONUMENT TYPE: FD. IRON PIN IN CLAY TILE  
ON SURFACE - BELOW:  
LEFT - CL PAV'T - RIGHT: 0.35'

FD. 1" SQ. IRON PIN IN CONCRETE IN CLAY TILE



## MISC. INFORMATION

FD. 1" SQ. IRON PIN AT SURFACE THAT APPEARED TO BE HIT BY SNOWPLOWS. SHOT DRILL HOLE IN TOP OF PIN AND DUG TO DETERMINE LENGTH OF PIN. FOUND CLAY TILE FILLED WITH CONCRETE 0.35' DOWN. PIN DID NOT APPEAR TO BE BENT. CUT TOP 3" OF PIN OFF AND RESET DRILL HOLE. PLACED MONUMENT BOX OVER PIN IN CLAY TILE.

APRIL 30, 2024  
SET MONUMENT BOX OVER  
1" SQUARE IRON PIN IN  
CONCRETE IN CLAY TILE

