OTTAWA COUNTY ENGINEERS OFFICE

@ T-214 OPFER-LENTZ RD.

ROUTE: STATE ROUTE #105

REFERENCE NO. 14-6-13-1 SE CORNER POST SEC. 14

HARRIS TWP.
SHEET 1 OF 1.

TOWNSHIP: HARRIS

TOWNSHIF. HARRI

SECTION: 14

PERSONNEL:

M. WITTMAN, P.S. J. ALLEN


D. HOHMAN, P.S. - ODOT T. ROUSOS - ODOT T 6 NR 13 E.

NORTHING:

EASTING:

DATE / WEATHER / TEMP:

MAY 23, 2013 OVERCAST - W-SW 66° F DATUM:

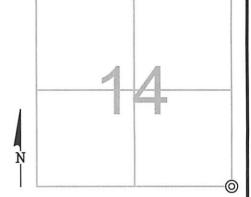

MONUMENT INFORMATION

MONUMENT TYPE: IRON PIN IN IRON PIPE ON SURFACE - <u>BELOW</u>: 0.62' LEFT - CL PAV'T - RIGHT: 2.50'

3/8" SQ. IRON PIN IN 1/2" O.D. IRON PIPE

MISC. INFORMATION

FD. PK NAIL ON SURFACE TIED W/ X-TIES AND DUG FOR STONE.
FD. PK AND SHINER 0.19' BELOW SURFACE 0.10' W AND 0.17' S OF
SURFACE NAIL. FD. MINE SPK AND WASHER 0.31' BELOW
SURFACE 0.11' W AND 0.16' S OF SURFACE NAIL. FD. PIN IN PIPE
0.62' BELOW SURFACE 0.14' W AND 0.21' S OF SURFACE NAIL. TIED
DOWN PIN IN PIPE W/ X-TIES AND CONTINUED TO DIG FOR STONE.
WENT DOWN 21" FROM SURFACE AND THEN PRODDED 3' DOWN
AND DID NOT LOCATE ANYTHING. PIPE WAS STILL FIRM AND
STRAIGHT - ACCEPTED PIN IN PIPE.

DATE UNKNOWN MAY 23, 2013 OPFER-LENTZ RD., T.R.#214 SET ROUND ODOT MONUMENT PAVING CONTRACTOR **BOX OVER PIN IN PIPE** REPLACED ROUND SET MAG MONUMENT BOX WITH IN DB SQUARE MONUMENT SIREN POLE **BOX IN CONCRETE** FD PΚ STATE ROUTE #105 "X" IN N&S USGS DISK