

# OTTAWA COUNTY ENGINEERS OFFICE


**REFERENCE NO.** 15-6-14-A  
 NW CORNER POST SECTION 15  
 HARRIS TWP.  
**SHEET** 1 OF 1.

**ROUTE:** T-45 HESSVILLE RD.  
**TOWNSHIP:** HARRIS  
**SECTION:** 15  
**T** 6 **N**R 14 **E.**

**PERSONNEL:**  
 M. WITTMAN, P.S.  
 M. BROUGH  
 R. LAJTI

**NORTHING:**  
**EASTING:**  
**DATUM:**

**DATE / WEATHER / TEMP:**  
 OCTOBER 9, 2003  
 SUNNY  
 58° F

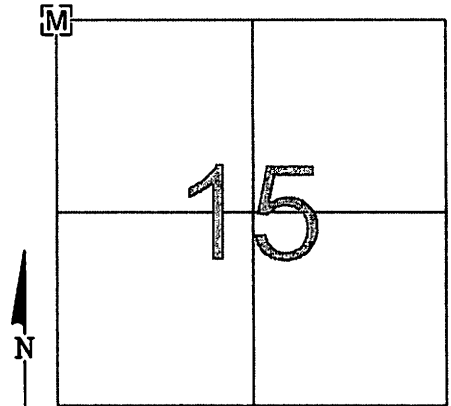

### MONUMENT INFORMATION

MONUMENT TYPE: FD 3/4" IRON PIN OVER MON BOX  
 ON SURFACE - BELOW: 0.16'  
 LEFT - CL PAV'T - RIGHT:


MON BOX BELOW IRON PIN IS 2.74' BELOW  
 SURFACE, PLACED PER BRIDGE PLANS - 1968.

### MISC. INFORMATION

PHOTO OF STONE NOT AVAILABLE

OCTOBER 9, 2003

PLACED MONUMENT BOX  
 OVER FOUND 3/4" IRON PIN

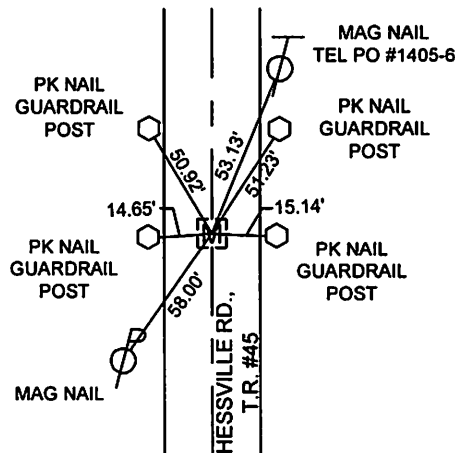

SHORT TIES

SET MAG NAIL N - 3.98'  
 SET MAG NAIL E - 3.99'  
 SET MAG NAIL S - 4.02'  
 SET MAG NAIL W - 4.01'

ADDITIONAL LONG TIES

W. END INT. VERT. & SLANT  
 CHAMFER N. FACE N. ABUT.  
 (NW END, N. ABUT.) - 75.48'

E. END INT. VERT. & SLANT  
 CHAMFER N. FACE N. ABUT.  
 (NE END, N. ABUT.) - 75.44'