


OTTAWA COUNTY ENGINEERS OFFICE

REFERENCE NO. 16-6-14-C
 NE CORNER POST SECTION 16
 HARRIS TWP.
SHEET 1 OF 1.

ROUTE: T-45 HESSVILLE RD.
TOWNSHIP: HARRIS
SECTION: 16
T 6 **NR** 14 **E.**

PERSONNEL:
 M. WITTMAN, P.S.
 M. BROUGH
 R. LAJTI

NORTHING:
EASTING:
DATUM:

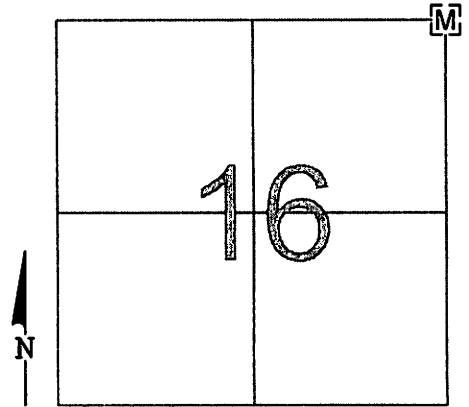

DATE / WEATHER / TEMP:
 OCTOBER 9, 2003
 SUNNY
 58° F

MONUMENT INFORMATION

MONUMENT TYPE: FD 3/4" IRON PIN OVER MON BOX
 ON SURFACE - BELOW: 0.16'
 LEFT - CL PAV'T - RIGHT:


MON BOX BELOW IRON PIN IS 2.74' BELOW
 SURFACE, PLACED PER BRIDGE PLANS - 1968.

MISC. INFORMATION

PHOTO OF STONE NOT AVAILABLE

OCTOBER 9, 2003

PLACED MONUMENT BOX
 OVER FOUND 3/4" IRON PIN

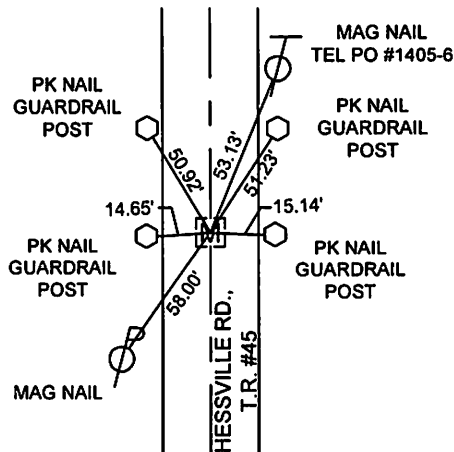

SHORT TIES

SET MAG NAIL N - 3.98'
 SET MAG NAIL E - 3.99'
 SET MAG NAIL S - 4.02'
 SET MAG NAIL W - 4.01'

ADDITIONAL LONG TIES

W. END INT. VERT. & SLANT
 CHAMFER N. FACE N. ABUT.
 (NW END, N. ABUT.) - 75.48'

E. END INT. VERT. & SLANT
 CHAMFER N. FACE N. ABUT.
 (NE END, N. ABUT.) - 75.44'