

# OTTAWA COUNTY ENGINEERS OFFICE

REFERENCE NO. 16-6-14-G  
SW CORNER POST SECTION 16  
HARRIS TWP.  
SHEET 1 OF 1.

ROUTE: C-6 ELMORE EASTERN RD.  
@ T-46 LINKER PORTAGE RD.

TOWNSHIP: HARRIS

SECTION: 16

T 6 NR 14 E.

PERSONNEL:  
M. WITTMAN, P.S.  
J. ALLEN


NORTHING:

EASTING:

DATUM:

DATE / WEATHER / TEMP:

MAY 23, 2014  
SUNNY, NW  
61° F

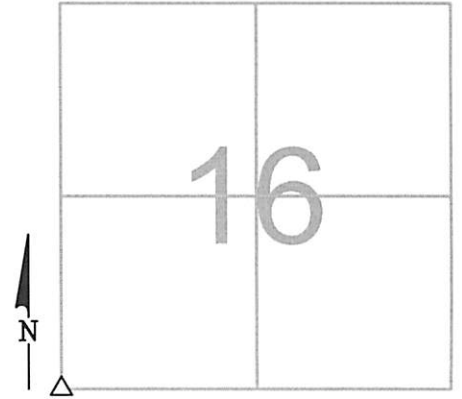

## MONUMENT INFORMATION

MONUMENT TYPE: FD 5" X 6" POINTED LIMESTONE  
ON SURFACE - BELOW: 1.10'  
LEFT - CL PAV'T - RIGHT: 2.5' (ELMORE EASTERN)  
LEFT - CL PAV'T - RIGHT: 7.0' (LINKER PORTAGE)

USED HIGH POINT OF STONE.



## MISC. INFORMATION

FD RR SPK WITH PUNCH HOLE ON SURFACE, TIED  
W/ X-TIES AND DUG FOR STONE. RR SPK WAS OVER  
HIGH POINT OF STONE.

MAY 23, 2014

SET 1" SQUARE IRON PIN  
IN MONUMENT BOX OVER  
STONE

