

# OTTAWA COUNTY ENGINEERS OFFICE

REFERENCE NO. 16-6-14-H  
SOUTH QUARTER POST SEC. 16  
HARRIS TWP.  
SHEET 1 OF 1.

ROUTE: C-6 ELMORE EASTERN RD.

TOWNSHIP: HARRIS

SECTION: 16

T 6 NR 14 E.

PERSONNEL:  
M. WITTMAN, P.S.  
J. ALLEN


NORTHING:

EASTING:

DATUM:

DATE / WEATHER / TEMP:

MAY 23, 2014  
SUNNY, NW  
72° F

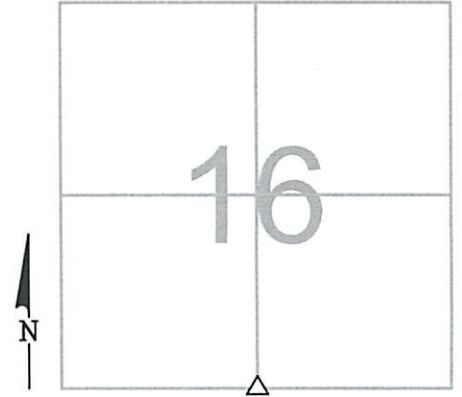

## MONUMENT INFORMATION

MONUMENT TYPE: FD 5" X 7" POINTED LIMESTONE  
ON SURFACE - BELOW: 1.65'  
LEFT - CL PAV'T - RIGHT: 3.15'

STONE HAS HIGH RIDGE RUNNING NORTH AND  
SOUTH - USED CENTER OF HIGH RIDGE.



## MISC. INFORMATION

FD RR SPK 0.10' BELOW SURFACE, TIED W/ X-TIES  
AND DUG FOR STONE. FD OLD AXE HANDLE ON  
EAST SIDE OF STONE (REMOVED). FD RR SPK WAS  
0.04' NORTH AND 0.04' WEST OF CENTER OF HIGH  
RIDGE USED.

MAY 23, 2014

SET 1" SQUARE IRON PIN  
IN MONUMENT BOX OVER  
STONE

