

OTTAWA COUNTY ENGINEERS OFFICE

REFERENCE NO. 16-6-14-I
 SOUTHEAST COR. SECTION 16
 HARRIS TWP.
SHEET 1 OF 1.

ROUTE: C-6 ELMORE EASTERN RD. @
 T-45 HESSVILLE RD.

TOWNSHIP: HARRIS

SECTION: 16

T 6 **NR** 14 **E.**

PERSONNEL:
 M. WITTMAN, P.S.
 J. UNDERWOOD, P.S.
 M. BROUGH
 R. LAJTI, JR.

NORTHING:

EASTING:

DATUM:



DATE / WEATHER / TEMP:
 OCTOBER 8, 2003
 SUNNY / BREEZY
 71° F

MONUMENT INFORMATION

MONUMENT TYPE: FD LIMESTONE W/ DRILL HOLE
 ON SURFACE - BELOW: 1.37'
LEFT - CL PAV'T - RIGHT: (T-45) RIGHT (C-6)

 STONE: 6" x 10" - HAD 1" SQ. WOODEN STAKE
 NEXT TO STONE.




MISC. INFORMATION

FD. RAILROAD SPIKE 1" BELOW SURFACE,
 REMOVED RAILROAD SPIKE AND CONTINUED TO
 STONE.

OCTOBER 8, 2003

SET 1" SQUARE IRON PIN
 IN MONUMENT BOX OVER
 STONE

ELMORE EASTERN RD., C.R. #6

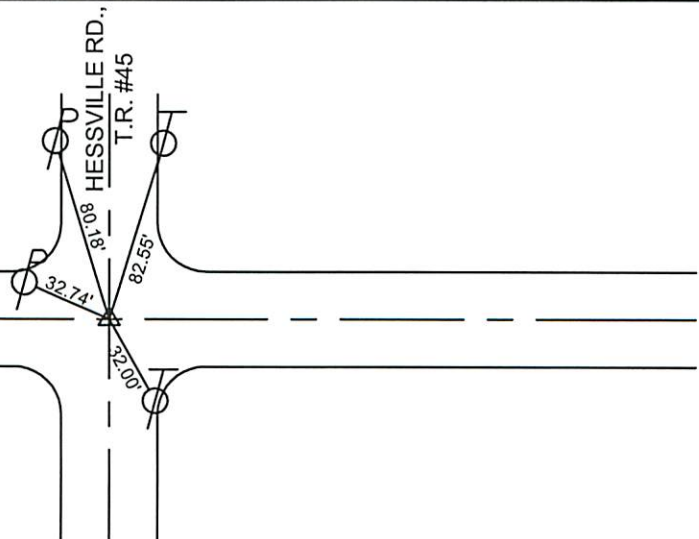

SHORT TIES

- FD. PK W - 6.01'
- FD. PK N - 2.99'
- FD. PK S - 3.00'
- SET MAG NAIL W - 3.00'