

OTTAWA COUNTY ENGINEERS OFFICE

REFERENCE NO. 17-6-14-C
NE CORNER POST SEC. 17
HARRIS TWP.
SHEET 1 OF 1.

ROUTE: T-46 LINKER-PORTAGE RD.

TOWNSHIP: HARRIS

SECTION: 17

T 6 NR 14 E.

PERSONNEL:
M. WITTMAN, P.S.
J. ALLEN


NORTHING:

EASTING:

DATUM:


DATE / WEATHER / TEMP:

APRIL 24, 2012
SUNNY N-NW
56° F

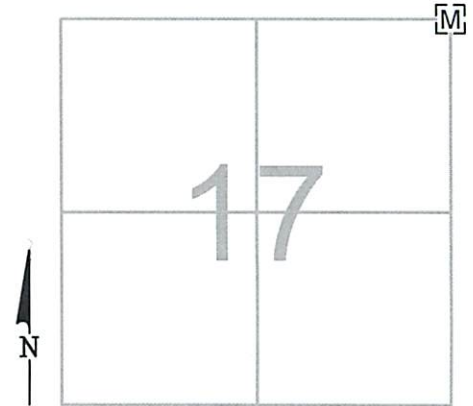

MONUMENT INFORMATION

MONUMENT TYPE: FD 1" SQ. IRON PIN IN MON. BOX
ON SURFACE - BELOW: 0.16'
LEFT - CL PAV'T - RIGHT: 0.45'

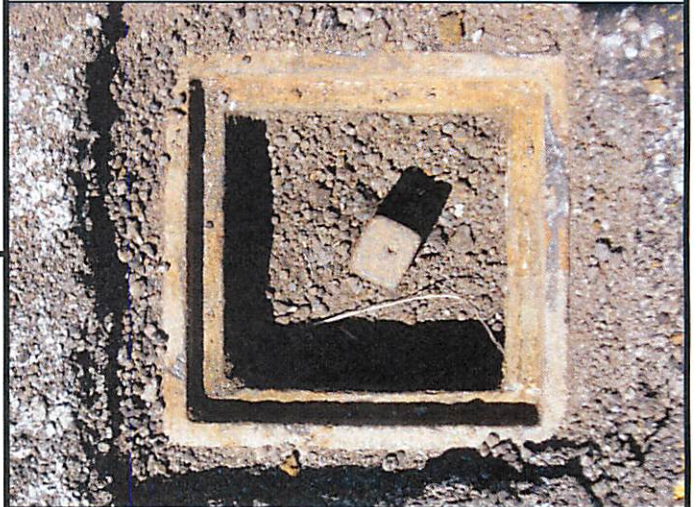

MISC. INFORMATION

PLACED RISER TO BRING TO SURFACE

