

# OTTAWA COUNTY ENGINEERS OFFICE

REFERENCE NO. 17-6-14-D  
WEST QUARTER POST SEC. 17  
HARRIS TWP.  
SHEET 1 OF 1.

ROUTE: T-47 SLEMMER - PORTAGE RD.  
@ T-85 NETCHER RD.

TOWNSHIP: HARRIS

SECTION: 17

T 6 NR 14 E.


NORTHING:

EASTING:

DATUM:

PERSONNEL:  
M. WITTMAN, P.S.  
J. ALLEN

DATE / WEATHER / TEMP:  
AUGUST 3, 2012  
SUNNY - SE  
89° F

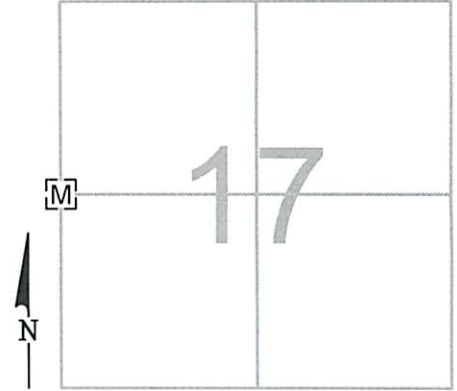

## MONUMENT INFORMATION

MONUMENT TYPE: FD 1" SQ IRON PIN IN MONUMENT BOX  
ON SURFACE - BELOW: 0.23'  
LEFT - CL PAV'T - RIGHT: 0.25'



## MISC. INFORMATION

8-3-12

NOTHING SUITABLE TO TIE  
THIS POINT TO IN THE  
VICINITY. POINT IS LOCATED  
AT THE APPROXIMATE  
INTERSECTION OF THE C/L  
OF PAVEMENT OF NETCHER  
RD. AND C/L OF PAVEMENT  
OF SLEMMER-PORTAGE RD.

SLEMMER - PORTAGE RD., T.R. #47

