

OTTAWA COUNTY ENGINEERS OFFICE


REFERENCE NO. 17-6-14-E
CENTER POST SEC. 17
HARRIS TWP.
SHEET 1 OF 1.

ROUTE: T-85 NETCHER RD.
TOWNSHIP: HARRIS
SECTION: 17
T 6 NR 14 E.

PERSONNEL:
M. WITTMAN, P.S.
J. ALLEN

NORTHING:
EASTING:
DATUM:

DATE / WEATHER / TEMP:
AUGUST 3, 2012
SUNNY - SE
95° F

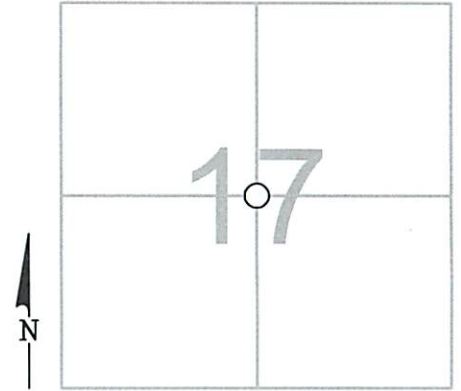

MONUMENT INFORMATION

MONUMENT TYPE: FD 1" SQ IRON PIN W/ DH
ON SURFACE - BELOW: 1.11'
LEFT - CL PAV'T - RIGHT: 0.30'

USED DRILL HOLE IN CENTER OF PIN



MISC. INFORMATION

SET 1" SQ. IRON PIN (OFFSET PIN) OVER IRON PIN
TO BRING CLOSER TO SURFACE.

AUGUST 3, 2012

SET 1" SQUARE IRON PIN
IN MONUMENT BOX OVER
IRON PIN

8-3-12

NOTHING SUITABLE TO TIE THIS POINT TO
IN THE VICINITY. POINT IS LOCATED AT THE
APPROXIMATE C/L OF PAVEMENT OF
NETCHER RD., 2,609 ± FEET EAST OF THE
WEST QUARTER POST OF SECTION 17.

NETCHER RD., T.R. #85

