

OTTAWA COUNTY ENGINEERS OFFICE

REFERENCE NO. 17-6-14-H
SOUTH QUARTER POST SEC. 17
HARRIS TWP.
SHEET 1 OF 1.

ROUTE: C-6 ELMORE EASTERN RD.

TOWNSHIP: HARRIS

SECTION: 17

T 6 NR 14 E.

PERSONNEL:

J. ALLEN
M. ULLRICH
S. ULLRICH


NORTHING:

EASTING:

DATUM:

DATE / WEATHER / TEMP:

SEPTEMBER 9, 2008
CLEAR
64° F

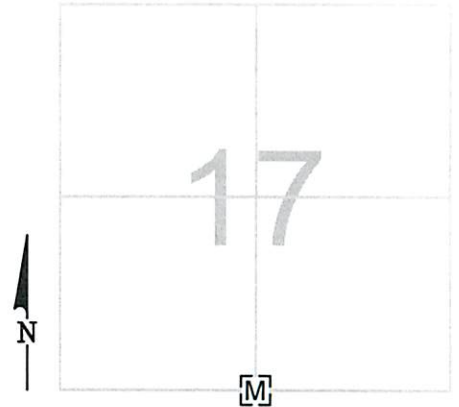

MONUMENT INFORMATION

MONUMENT TYPE: FD. 1" SQUARE IRON PIN IN
MONUMENT BOX
ON SURFACE - BELOW: 0.10'
LEFT - CL PAV'T - RIGHT: 1.0'



MISC. INFORMATION

