

# OTTAWA COUNTY ENGINEERS OFFICE

**REFERENCE NO.** 18-6-14-F  
EAST QUARTER POST SEC. 18  
HARRIS TWP.  
**SHEET** 1 OF 1.

**ROUTE:** T-47 SLEMMER - PORTAGE RD.  
@ T-85 NETCHER RD.

**TOWNSHIP:** HARRIS

**SECTION:** 18

T 6 NR 14 E.


**NORTHING:**

**EASTING:**

**DATUM:**

**PERSONNEL:**  
M. WITTMAN, P.S.  
J. ALLEN

**DATE / WEATHER / TEMP:**  
AUGUST 3, 2012  
SUNNY - SE  
89° F

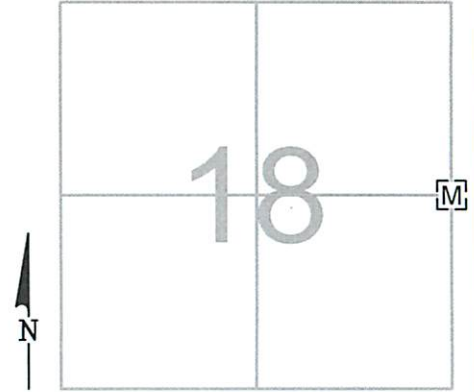

## MONUMENT INFORMATION

MONUMENT TYPE: FD 1" SQ IRON PIN IN MONUMENT BOX  
ON SURFACE - BELOW: 0.23'  
LEFT - CL PAV'T - RIGHT: 0.25'



## MISC. INFORMATION

8-3-12

NOTHING SUITABLE TO TIE  
THIS POINT TO IN THE  
VICINITY. POINT IS LOCATED  
AT THE APPROXIMATE  
INTERSECTION OF THE C/L  
OF PAVEMENT OF NETCHER  
RD. AND C/L OF PAVEMENT  
OF SLEMMER-PORTAGE RD.

