

OTTAWA COUNTY ENGINEERS OFFICE

REFERENCE NO. 18-6-14-G
SW CORNER POST SEC. 18
HARRIS TWP.
SHEET 1 OF 1.

ROUTE: C-18 PORTAGE RIVER SO. RD.
@ STATE ROUTE #51

TOWNSHIP: HARRIS

SECTION: 18

T 6 NR 14 E.


NORTHING:

EASTING:

DATUM:

PERSONNEL:
M. WITTMAN, P.S.
J. ALLEN

DATE / WEATHER / TEMP:
MAY 11, 2015
SUNNY - SW
84° F

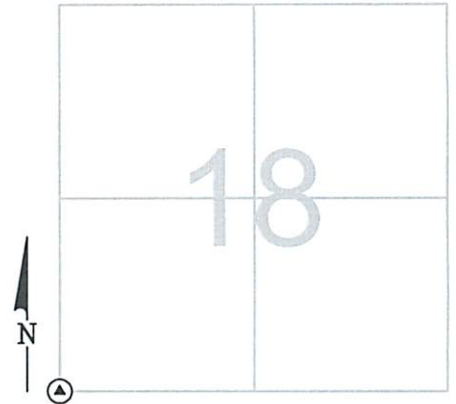

MONUMENT INFORMATION

MONUMENT TYPE: FD 2 3/4" Ø BRASS DISK IN CONC
ON SURFACE - BELOW:
LEFT - CL PAV'T - RIGHT:
BRASS ODOT RW DISK IN 6" Ø CONCRETE



MISC. INFORMATION

IN STONE DRIVE FOR 209 RICE STREET, ELMORE

THIS IS A CLOSING CORNER

