

OTTAWA COUNTY ENGINEERS OFFICE

REFERENCE NO. 18-6-14-H
S QUARTER POST SECTION 18
HARRIS TWP.

ROUTE: C-6 ELMORE EASTERN RD.
@ T-48 DISCHINGER RD.
A.K.A. AMES ST.

SHEET 1 OF 1.

TOWNSHIP: HARRIS

PERSONNEL:
R. STEINMILLER, P.S.
J. UNDERWOOD

SECTION: 18


T 6 **NR** 14 **E.**

NORTHING:

EASTING:

DATE / WEATHER / TEMP:
UNKNOWN

DATUM:

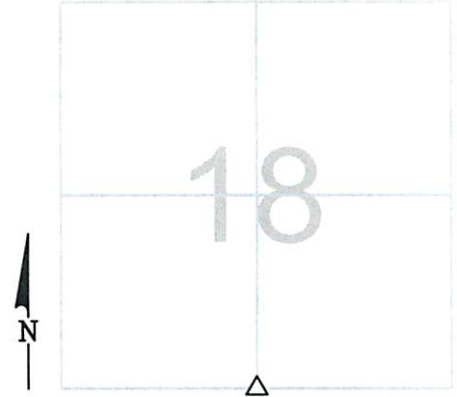

MONUMENT INFORMATION

MONUMENT TYPE: FD STONE W/ DRILL HOLE
ON SURFACE - BELOW: 0.90'
LEFT - CL PAV'T - RIGHT:

TRIANGULAR LIMESTONE: 11" x 7-1/2" x 10"



MISC. INFORMATION

DATE UNKNOWN: R. STEINMILLER & J.
UNDERWOOD SET IRON PIN IN MONUMENT BOX
OVER STONE.

9-5-07: M. WITTMAN, P.S., J. ALLEN & S. ULLRICH
NEW TIES TO IRON PIN IN MONUMENT BOX

