

OTTAWA COUNTY ENGINEERS OFFICE

REFERENCE NO. 19-6-14-H
 SOUTH QUARTER POST SEC. 19
 HARRIS TWP.
 SHEET 1 OF 1.

ROUTE: T-48 DISCHSINGER RD.
 @ COUNTY LINE

TOWNSHIP: HARRIS


SECTION: 19

T 6 NR 14 E.

NORTHING:

EASTING:

DATUM:

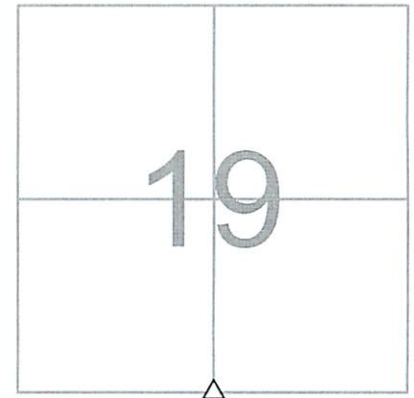

PERSONNEL:
 M. WITTMAN, P.S.
 J. ALLEN

DATE / WEATHER / TEMP:
 JUNE 16, 2016
 SUNNY - N
 80° F

MONUMENT INFORMATION

MONUMENT TYPE: FD. POINTED HARDHEAD STONE
 ON SURFACE - BELOW: 1.25'
LEFT - CL PAV'T - RIGHT: 3.80'

11" x 7" POINTED HARDHEAD.

USED HIGH POINT ON SOUTH END OF STONE.



MISC. INFORMATION

FD. YELLOW SANDUSKY COUNTY TARGET WITH
 MAG NAIL IN CENTER ON SURFACE, TIED / X-TIES
 AND DUG FOR STONE. FD. RR SPIKE 0.66' BELOW
 SURFACE THAT MATCHED MAG NAIL. RR SPIKE
 WAS 0.08' EAST AND 0.06' NORTH OF POINT USED
 ON STONE.

JUNE 16, 2016

SET 1" SQUARE IRON PIN
 IN MONUMENT BOX OVER
 STONE

