

OTTAWA COUNTY ENGINEERS OFFICE

REFERENCE NO. 2-6-14-A
NW CORNER POST SEC. 2
HARRIS TWP.
SHEET 1 OF 1.

ROUTE: STATE ROUTE #163
@ STATE ROUTE #590

TOWNSHIP: HARRIS


SECTION: 2

T 6 NR 14 E.

NORTHING:

EASTING:

DATUM:

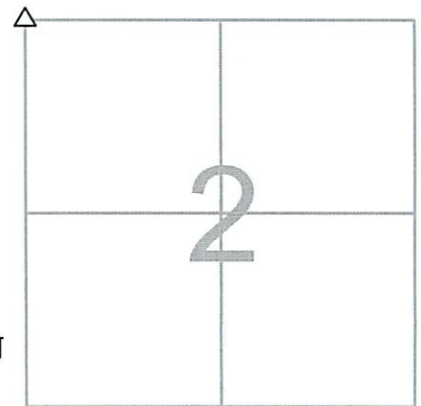

PERSONNEL:

M. WITTMAN, P.S.
J. ALLEN
S. CODER, P.S. - ODOT
J. RHODES - ODOT
SHELLY CO.

DATE / WEATHER / TEMP:

AUGUST 22, 2013
OVERCAST - W,SW
70° F

MONUMENT INFORMATION

MONUMENT TYPE: FD 5" X 6" LIMESTONE
ON SURFACE - BELOW: 2.09'
LEFT - CL PAVT - RIGHT:

POINTED STONE WITH SMALL DRILL HOLE IN PIPE
MARK ON POINTED SE CORNER - USED DRILL HOLE



MISC. INFORMATION

FD 3/4" Ø BY 19" LONG IRON PIPE 0.51' BELOW SURFACE.
IRON PIPE PER ODOT RECORDS. REMOVED IRON PIPE
AND DUG FOR STONE.

SET 1" Ø X 19" LONG IRON PIN IN FLOODED MASONRY
SAND IN 6" Ø PVC IN MONUMENT BOX OVER STONE WITH
ODOT AND SHELLY CO. ASSISTANCE

AUGUST 22, 2013

SET 1" Ø IRON PIN
IN MONUMENT BOX
OVER STONE

