

OTTAWA COUNTY ENGINEERS OFFICE

REFERENCE NO. 2-6-14-F
EAST QUARTER POST SEC. 2
HARRIS TWP.
SHEET 1 OF 1.

PERSONNEL:
M. WITTMAN, P.S.
J. ALLEN

DATE / WEATHER / TEMP:
AUGUST 25, 2022
SUNNY - HUMID
76° F

ROUTE: T-22 LICKERT-HARDER RD.

TOWNSHIP: HARRIS


SECTION: 2

T 6 NR 14 E.

NORTHING:

EASTING:

DATUM:

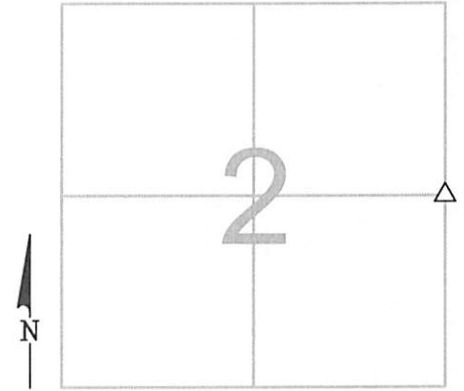

MONUMENT INFORMATION

MONUMENT TYPE: FD POINTED STONE
ON SURFACE - BELOW: 1.15'
LEFT - CL PAV'T - RIGHT: 1.50'
(5.8' EAST OF WEST EOP)

5-1/2" x 5-1/2" TRIANGULAR POINTED STONE.
USED HIGH POINT ON STONE.



MISC. INFORMATION

FOUND DIG HOLE (NOTHING FOUND IN HOLE) IN
PAVEMENT WITH RAILROAD SPIKE TIES ON EACH
EDGE OF PAVEMENT PER RECORDS. THERE WERE
3 RAILROAD SPIKES DRIVEN INTO THE CLAY SOIL
NEXT TO THE STONE.

AUGUST 25, 2022

SET 1" SQUARE IRON PIN
IN MONUMENT BOX OVER
STONE

