

OTTAWA COUNTY ENGINEERS OFFICE

REFERENCE NO. 20-6-14-C
NE CORNER POST SECTION 20
HARRIS TWP.
SHEET 1 OF 1.

ROUTE: C-6 ELMORE EASTERN RD.
@ T-46 LINKER PORTAGE RD.

TOWNSHIP: HARRIS

SECTION: 20

T 6 NR 14 E.


NORTHING:

EASTING:

DATUM:

PERSONNEL:
M. WITTMAN, P.S.
J. ALLEN

DATE / WEATHER / TEMP:
MAY 23, 2014
SUNNY, NW
61° F

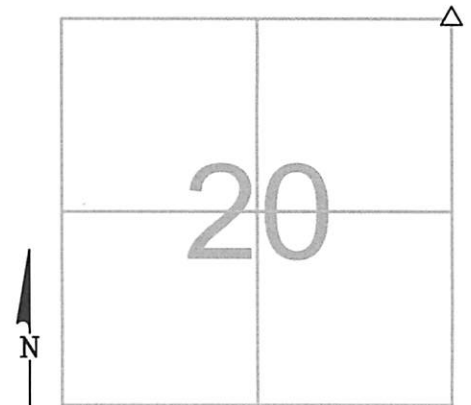

MONUMENT INFORMATION

MONUMENT TYPE: FD 5" X 6" POINTED LIMESTONE
ON SURFACE - BELOW: 1.10'
LEFT - CL PAV'T - RIGHT: 2.5' (ELMORE EASTERN)
LEFT - CL PAV'T - RIGHT: 7.0' (LINKER PORTAGE)

USED HIGH POINT OF STONE.



MISC. INFORMATION

FD RR SPK WITH PUNCH HOLE ON SURFACE, TIED
W/ X-TIES AND DUG FOR STONE. RR SPK WAS OVER
HIGH POINT OF STONE.

MAY 23, 2014

SET 1" SQUARE IRON PIN
IN MONUMENT BOX OVER
STONE

