

OTTAWA COUNTY ENGINEERS OFFICE

REFERENCE NO. 21-6-14-B
NORTH QUARTER POST SEC. 21
HARRIS TWP.
SHEET 1 OF 1.

ROUTE: C-6 ELMORE EASTERN RD.

TOWNSHIP: HARRIS

SECTION: 21

T 6 NR 14 E.


NORTHING:

EASTING:

DATUM:

PERSONNEL:
M. WITTMAN, P.S.
J. ALLEN

DATE / WEATHER / TEMP:
MAY 23, 2014
SUNNY, NW
72° F

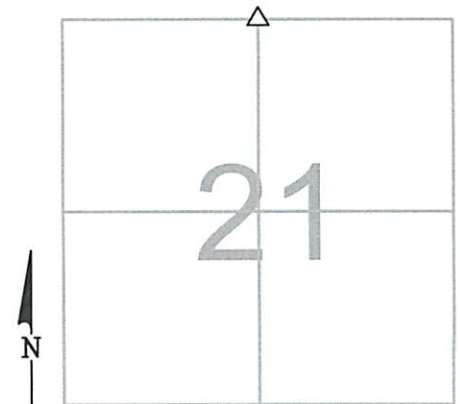

MONUMENT INFORMATION

MONUMENT TYPE: FD 5" X 7" POINTED LIMESTONE
ON SURFACE - BELOW: 1.65'
LEFT - CL PAV'T - RIGHT: 3.15'

STONE HAS HIGH RIDGE RUNNING NORTH AND
SOUTH - USED CENTER OF HIGH RIDGE.



MISC. INFORMATION

FD RR SPK 0.10' BELOW SURFACE, TIED W/ X-TIES
AND DUG FOR STONE. FD OLD AXE HANDLE ON
EAST SIDE OF STONE (REMOVED). FD RR SPK WAS
0.04' NORTH AND 0.04' WEST OF CENTER OF HIGH
RIDGE USED.

MAY 23, 2014

SET 1" SQUARE IRON PIN
IN MONUMENT BOX OVER
STONE

