

OTTAWA COUNTY ENGINEERS OFFICE

REFERENCE NO. 21-6-14-E
CENTER POST SEC. 21
HARRIS TWP.
SHEET 1 OF 1.

ROUTE: T-86 YEASTING RD.

TOWNSHIP: HARRIS

SECTION: 21

T 6 NR 14 E.

PERSONNEL:
M. WITTMAN, P.S.
J. ALLEN


NORTHING:

EASTING:

DATUM:

DATE / WEATHER / TEMP:

AUGUST 3, 2012
SUNNY - SE
88° F

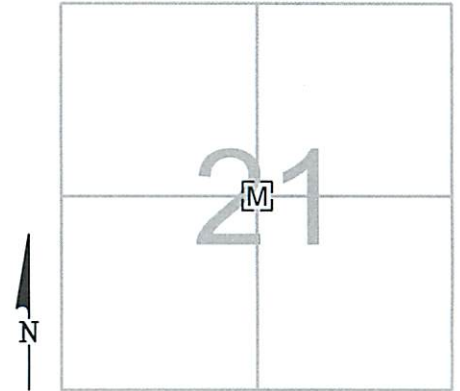

MONUMENT INFORMATION

MONUMENT TYPE: 1-1/4" X 1" IRON PIN IN MON BOX
ON SURFACE - BELOW: 0.12'
LEFT - CL PAV'T - RIGHT:



MISC. INFORMATION

