

OTTAWA COUNTY ENGINEERS OFFICE

REFERENCE NO. 21-6-14-F
 EAST QUARTER POST SECTION
 21 HARRIS TWP.
SHEET 1 OF 1.

ROUTE: T-45 HESSVILLE RD. @
 T-86 YEASTING RD.

TOWNSHIP: HARRIS

SECTION: 21


T 6 **NR** 14 **E.**

PERSONNEL:
 M. WITTMAN, P.S.
 M. BROUGH
 R. LAJTI, JR.

NORTHING:

EASTING:

DATUM:

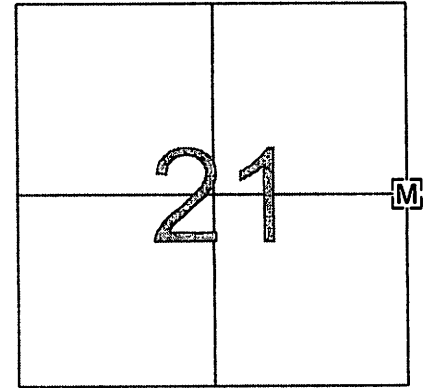

DATE / WEATHER / TEMP:
 OCTOBER 8, 2003
 SUNNY / BREEZY
 75° F

MONUMENT INFORMATION

MONUMENT TYPE: FD 1" SQ. IRON PIN W/ DRILL HOLE
ON SURFACE - BELOW:
LEFT - CL PAV'T - RIGHT: 5.70' (T-45)

IRON PIN IN MON. BOX

PHOTO OF STONE NOT AVAILABLE

MISC. INFORMATION

ADDITIONAL TIES
 C/L N. END 48" RCP X-OVER W. SIDE T-45 - 46.13'
 PLUMBED
 FD. "X" S. END 48" RCP X-OVER W. SIDE T-45 - 24.33'
 PLUMBED

