

OTTAWA COUNTY ENGINEERS OFFICE

REFERENCE NO. 21-6-14-G
 SW CORNER POST SEC. 21
 HARRIS TWP.
 SHEET 1 OF 1.

ROUTE: T-46 LINKER-PORTAGE RD.
 @ SANDUSKY COUNTY LINE

TOWNSHIP: HARRIS


SECTION: 21

T 6 NR 14 E.

NORTHING:

EASTING:

DATUM:

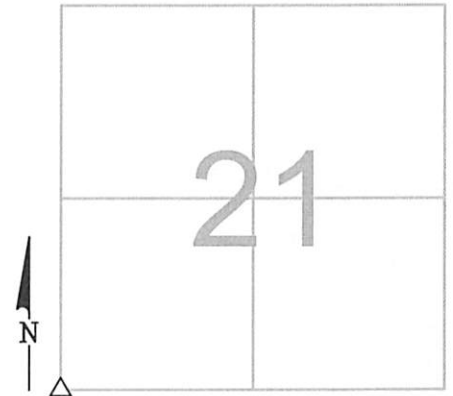

PERSONNEL:
 M. WITTMAN, P.S.
 J. ALLEN

DATE / WEATHER / TEMP:
 AUGUST 31, 2022
 SUNNY
 65° F

MONUMENT INFORMATION

MONUMENT TYPE: FD LIMESTONE
 ON SURFACE - BELOW: 1.33'
LEFT - CL PAV'T - RIGHT: 5.8'
 10" x 8" IRREGULAR SHAPED LIMESTONE W/
 CHISLED "X" ON HIGH POINT ON SOUTH END
 USED "X" ON HIGH POINT AS POINT



MISC. INFORMATION

FD RAILROAD SPIKE 0.15' BELOW SURFACE, SHOT
 WITH GPS AND DUG FOR STONE. RAILROAD SPIKE
 WAS 0.09' NORTH AND 0.02' EAST OF CHISLED "X"
 ON THE STONE.

AUGUST 31, 2022

SET 1" SQUARE IRON PIN
 IN MONUMENT BOX OVER
 STONE

