

OTTAWA COUNTY ENGINEERS OFFICE

REFERENCE NO. 22-6-14-D
WEST QUARTER POST SECTION
22 HARRIS TWP.
SHEET 1 OF 1.

ROUTE: T-45 HESSVILLE RD. @
T-86 YEASTING RD.

TOWNSHIP: HARRIS

SECTION: 22

T 6 NR 14 E.


NORTHING:

EASTING:

DATUM:

PERSONNEL:
M. WITTMAN, P.S.
M. BROUGH
R. LAJTI, JR.

DATE / WEATHER / TEMP:
OCTOBER 8, 2003
SUNNY / BREEZY
75° F

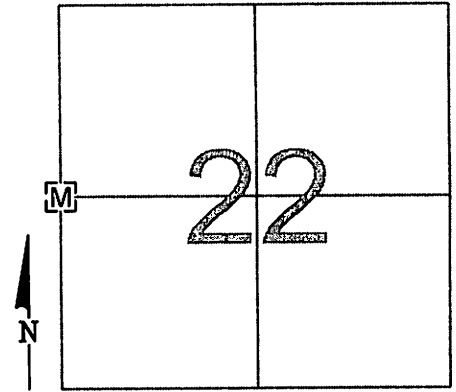

MONUMENT INFORMATION

MONUMENT TYPE: FD 1" SQ. IRON PIN W/ DRILL HOLE
ON SURFACE - BELOW:
LEFT - CL PAV'T - RIGHT: 5.70' (T-45)

IRON PIN IN MON. BOX

PHOTO OF STONE NOT AVAILABLE

MISC. INFORMATION

ADDITIONAL TIES

C/L N. END 48" RCP X-OVER W. SIDE T-45 - 46.13'
PLUMBED
FD. "X" S. END 48" RCP X-OVER W. SIDE T-45 - 24.33'
PLUMBED

