

OTTAWA COUNTY ENGINEERS OFFICE

REFERENCE NO. 22-6-14-G
SW CORNER POST SEC. 22
HARRIS TWP.
SHEET 1 OF 1.

ROUTE: T-45 HESSVILLE RD.
@ SANDUSKY COUNTY LINE

TOWNSHIP: HARRIS

SECTION: 22

T 6 NR 13 E.

PERSONNEL:
M. WITTMAN, P.S.
J. ALLEN


NORTHING:

EASTING:

DATUM:

DATE / WEATHER / TEMP:

SEPTEMBER 8, 2021
SUNNY - S, SW
74° F

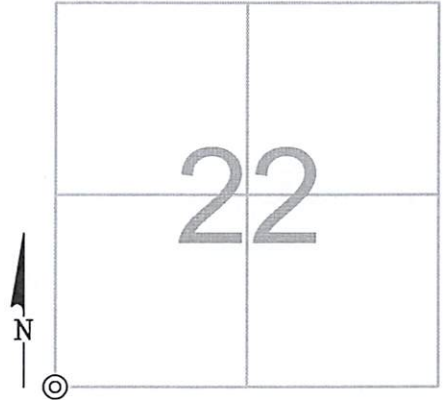

MONUMENT INFORMATION

MONUMENT TYPE: FD IRON PIPE
ON SURFACE - BELOW: 0.25'
LEFT - CL PAV'T - RIGHT: 2.75'

FD 1" Ø IRON PIPE WITH PK NAIL

USED PK NAIL AS POINT



MISC. INFORMATION

IRON PIPE IS DESCRIBED IN NUMEROUS SURVEYS
FOUND IN BOTH OTTAWA COUNTY AND SANDUSKY
COUNTY RECORDS.

IRON PIPE WAS SOLID AND DID NOT MOVE

SEPTEMBER 8, 2021

SET MONUMENT BOX OVER
PIPE

