

OTTAWA COUNTY ENGINEERS OFFICE

REFERENCE NO. 23-6-14-B
NORTH QUARTER POST SEC. 23
HARRIS TWP.
SHEET 1 OF 1.

ROUTE: C-6 ELMORE - EASTERN RD.

TOWNSHIP: HARRIS

SECTION: 23


T 6 NR 14 E.

PERSONNEL:
M. WITTMAN, P.S.
J. ALLEN
E. KOCH

NORTHING:

EASTING:

DATUM:

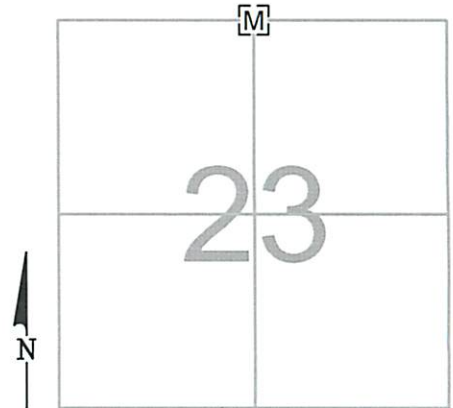

DATE / WEATHER / TEMP:
MAY 7, 2010
OVERCAST
60° F

MONUMENT INFORMATION

MONUMENT TYPE: FD. 1" SQ. IRON PIN IN
MONUMENT BOX
ON SURFACE - BELOW: 0.57'
LEFT - CL PAV'T - RIGHT: 7.80'



MISC. INFORMATION

ELMORE - EASTERN RD., C.R. #6

