

# OTTAWA COUNTY ENGINEERS OFFICE

REFERENCE NO. 23-6-14-F  
 EAST QUARTER POST SEC. 23  
 HARRIS TWP.  
 SHEET 1 OF 1.

ROUTE: T-43 SLEMMER-PORTAGE RD.

TOWNSHIP: HARRIS


SECTION: 23

T 6 NR 14 E.

NORTHING:

EASTING:

DATUM:

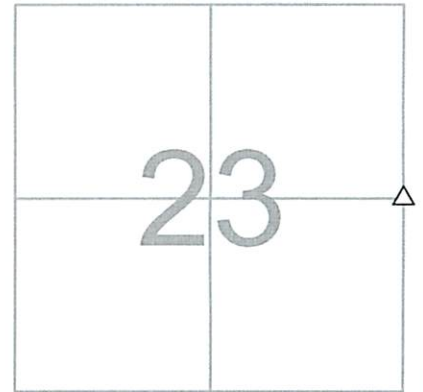

PERSONNEL:  
 M. WITTMAN, P.S.  
 J. ALLEN  
 V. SZABO

DATE / WEATHER / TEMP:  
 JUNE 26, 2018  
 SUNNY - E / NE  
 74° F

### MONUMENT INFORMATION

MONUMENT TYPE: FD. STONE  
 ON SURFACE - BELOW: 1.52'  
LEFT - CL PAV'T - RIGHT: 6.35' (1.3' IN FROM W. E.O.P.)

10" x 8" OVAL STONE WITH DRILL HOLE

USED DRILL HOLE



### MISC. INFORMATION

NOTHING BUT A DIG HOLE FOUND ON SURFACE.  
 FD 3" Ø SCRAP PIPE AND 1" STEEL PLATE 0.70'  
 BELOW SURFACE WHICH WAS OVER STONE. A  
 2" x 2" WOOD HUB IS ON SOUTHWEST SIDE OF  
 STONE WHICH MATCHED RECORDS.

JUNE 26, 2018

SET 1" SQUARE IRON PIN  
 IN MONUMENT BOX OVER  
 STONE

2' UP FROM BASE  
 ON CENTER OF E.  
 FACE TAPERED  
 CONCRETE PILLAR  
 14" x 10" BASE

