

OTTAWA COUNTY ENGINEERS OFFICE

REFERENCE NO. 24-6-13-A
 NW CORNER POST SEC. 24
 HARRIS TWP.
SHEET 1 OF 1.

ROUTE: STATE ROUTE #105
 @ T-214 OPFER-LENTZ RD.

TOWNSHIP: HARRIS


SECTION: 24

T 6 **NR** 13 **E.**

NORTHING:

EASTING:

DATUM:

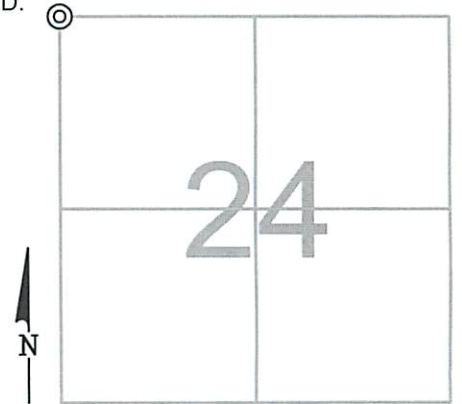

PERSONNEL:

M. WITTMAN, P.S.
 J. ALLEN
 D. HOHMAN, P.S. - ODOT
 T. ROUSOS - ODOT

DATE / WEATHER / TEMP:

MAY 23, 2013
 OVERCAST - W-SW
 66° F

MONUMENT INFORMATION

MONUMENT TYPE: IRON PIN IN IRON PIPE
 ON SURFACE - BELOW: 0.62'
LEFT - CL PAV'T - RIGHT: 2.50'

 3/8" SQ. IRON PIN IN 1/2" O.D. IRON PIPE



MISC. INFORMATION

FD. PK NAIL ON SURFACE TIED W/ X-TIES AND DUG FOR STONE.
 FD. PK AND SHINER 0.19' BELOW SURFACE 0.10' W AND 0.17' S OF
 SURFACE NAIL. FD. MINE SPK AND WASHER 0.31' BELOW
 SURFACE 0.11' W AND 0.16' S OF SURFACE NAIL. FD. PIN IN PIPE
 0.62' BELOW SURFACE 0.14' W AND 0.21' S OF SURFACE NAIL. TIED
 DOWN PIN IN PIPE W/ X-TIES AND CONTINUED TO DIG FOR STONE.
 WENT DOWN 21" FROM SURFACE AND THEN PRODDED 3' DOWN
 AND DID NOT LOCATE ANYTHING. PIPE WAS STILL FIRM AND
 STRAIGHT - ACCEPTED PIN IN PIPE.

MAY 23, 2013

SET ROUND ODOT MONUMENT
 BOX OVER PIN IN PIPE

DATE UNKNOWN

PAVING CONTRACTOR
 REPLACED ROUND
 MONUMENT BOX WITH
 SQUARE MONUMENT
 BOX IN CONCRETE

