

# OTTAWA COUNTY ENGINEERS OFFICE

REFERENCE NO. 24-6-13-C  
NE CORNER POST SEC. 24  
HARRIS TWP.  
SHEET 1 OF 1.

ROUTE: C-18 PORTAGE RIVER SO. RD.  
@ STATE ROUTE #51

TOWNSHIP: HARRIS

SECTION: 24

T 6 NR 13 E.


NORTHING:

EASTING:

DATUM:

PERSONNEL:  
M. WITTMAN, P.S.  
J. ALLEN

DATE / WEATHER / TEMP:  
MAY 11, 2015  
SUNNY - SW  
84° F

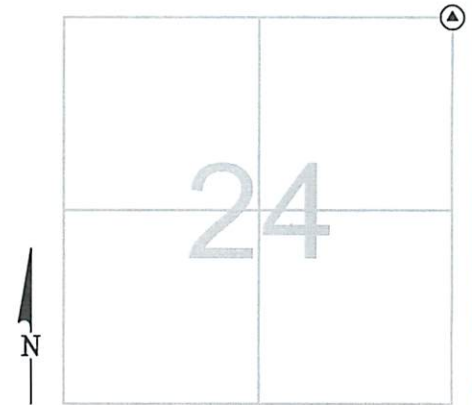

## MONUMENT INFORMATION

MONUMENT TYPE: FD 2 3/4" Ø BRASS DISK IN CONC  
ON SURFACE - BELOW:  
LEFT - CL PAV'T - RIGHT:  
BRASS ODOT R/W DISK IN 6" Ø CONCRETE



## MISC. INFORMATION

IN GRASS YARD OF 209 RICE STREET, ELMORE

