OTTAWA COUNTY ENGINEERS OFFICE

REFERENCE NO. 24-6-13-E

INTERIOR CORNER POST SEC. 24

HARRIS TWP.

SHEET 1 OF 1.

ROUTE: C-18 PORTAGE RIVER SOUTH RD.

(NORTH OF ROAD)

TOWNSHIP: HARRIS

SECTION: 24

PERSONNEL:

M. WITTMAN, P.S.

J. ALLEN

T 6 NR 13 E.

NORTHING: 656,530.0800

EASTING: 1,746,684.8340


DATE / WEATHER / TEMP:

OCTOBER 22, 2013

SUNNY - SW

49° F



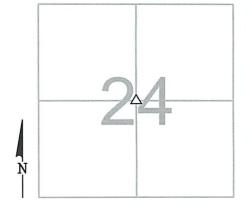

MONUMENT INFORMATION

MONUMENT TYPE: FD. RECTANGULER LIMESTONE ON SURFACE - BELOW: 0.50'

LEFT - CL PAV'T - RIGHT:

STONE IS 12" N/S x 8" E/W W/ DH IN SE CORNER

USED DRILL HOLE

MISC. INFORMATION

- THERE IS A 1/2" IRON PIN ON S SIDE OF STONE
- DRILL HOLE WAS LOCATED BY ORANGE ARROWS
- IRON PIN IS 0.15' S AND 0.20' W OF DRILL HOLE
- STONE IS 4' E OF E BANK OF DITCH AND 25' ± FROM S EDGE OF WOODED AREA
- SET ORANGE SURVEY MARKER DELINEATOR 1.00' EAST OF STONE



OCTOBER 22, 2013 OHIO VRS COORDINATES N = 656.230.0800E = 1.746.684.8340 DATUM = NAD83 (CORS96)

