

OTTAWA COUNTY ENGINEERS OFFICE

REFERENCE NO. 24-6-13-H
SOUTH QUARTER POST SEC. 24
HARRIS TWP.
SHEET 1 OF 1.

ROUTE: T-49 SCHUTT RD.
(EAST OF ROAD)

TOWNSHIP: HARRIS

SECTION: 24

T 6 NR 13 E.

NORTHING:


EASTING:

DATUM:

PERSONNEL:
M. WITTMAN, P.S.
J. ALLEN

DATE / WEATHER / TEMP:

OCTOBER 22, 2013
SUNNY - SW
45° F

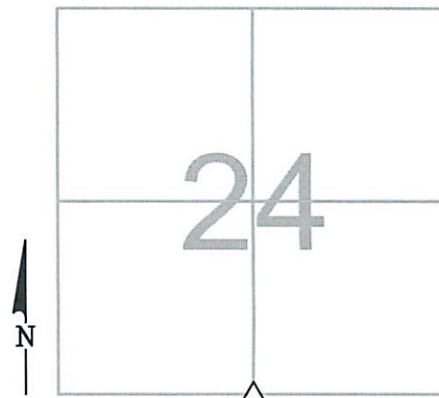

MONUMENT INFORMATION

MONUMENT TYPE: FD. RECT. POINTED STONE
ON SURFACE - BELOW:
LEFT - CL PAV'T - RIGHT: 139.60'

STONE IS 6-1/2" N/S x 5" E/W
1/2" IRON PIPE ON WEST SIDE OF STONE
USED HIGH POINT ON STONE (INLINE WITH PIPE TO WEST)



MISC. INFORMATION

SET ORANGE SURVEY MARKER DELINEATOR 1.00'
SOUTH OF STONE

