

# OTTAWA COUNTY ENGINEERS OFFICE

REFERENCE NO. 24-6-14-H  
SOUTH QUARTER POST SEC. 24  
HARRIS TWP.  
SHEET 1 OF 1.

ROUTE: T-9 SCHNEIDER RD.

TOWNSHIP: HARRIS

SECTION: 24

T 6 NR 14 E.


NORTHING:

EASTING:

DATUM:

PERSONNEL:  
M. WITTMAN, P.S.  
J. ALLEN  
V. SZABO

DATE / WEATHER / TEMP:  
JUNE 26, 2018  
SUNNY - E / NE  
72° F

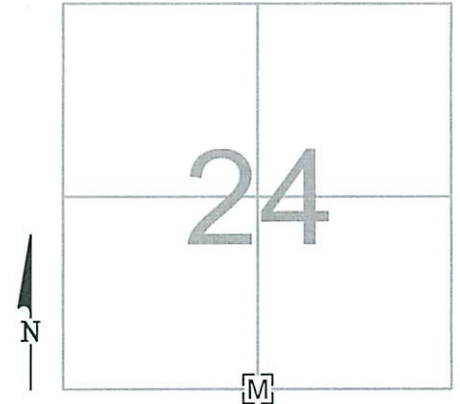

## MONUMENT INFORMATION

MONUMENT TYPE: FD. 3/4" Ø I. PIN IN MON BOX  
ON SURFACE - BELOW: 0.36'  
LEFT - CL PAV'T - RIGHT: 4.18'

ADDED RISERS TO BRING TO SURFACE



## MISC. INFORMATION

JUNE 26, 2018

ADDED RISERS TO BRING TO SURFACE

