

OTTAWA COUNTY ENGINEERS OFFICE

REFERENCE NO. 3-6-14-A
 NW CORNER POST SEC. 3
 HARRIS TWP.
SHEET 1 OF 1.

ROUTE: STATE ROUTE #163
 @ T-21 STANGE RD.

TOWNSHIP: HARRIS

SECTION: 3

T 6 **NR** 14 **E.**


NORTHING:

EASTING:

DATUM:

PERSONNEL:
 M. WITTMAN, P.S.
 J. ALLEN
 M. BROUGH
 C. MILLER

DATE / WEATHER / TEMP:
 APRIL 30, 2013
 SUNNY - S, SW
 72° F

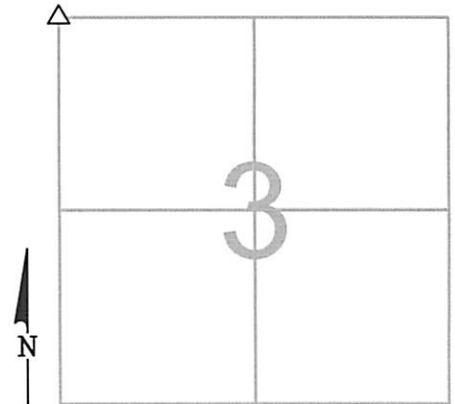

MONUMENT INFORMATION

MONUMENT TYPE: FD 4" X 9" HARDHEAD STONE
 ON SURFACE - BELOW: 1.92'
LEFT - CL PAV'T - RIGHT: 6.84' (SR 163) 2.0' L (T-21)

STONE HAD NO DISTINGUISHING MARKS, SET AND
 USED SHALLOW DH IN CENTER OF STONE.



MISC. INFORMATION

FD MINE SPIKE AND WASHER 0.50' BELOW SURFACE, TIED W/ X-TIES
 AND DUG FOR STONE. FD NAIL AND SHINER 0.86' BELOW SURFACE
 0.04' W AND 0.05' S OF SURFACE NAIL. FD 1" X 2" WOOD HUB 0.96'
 BELOW SURFACE 0.19' E AND 0.21' S OF SURFACE NAIL. DH USED
 ON STONE WAS 0.07' E AND 0.27' S OF SURFACE NAIL. STONE WAS
 WITNESSED BY JAMES WITTMAN.

8-22-13: SET 1" Ø X 19" LONG IRON PIN IN FLOODED MASONRY SAND
 IN 6" Ø PVC IN MONUMENT BOX WITH ODOT AND SHELLY CO.
 ASSISTANCE.

AUGUST 22, 2013

SET 1" Ø IRON PIN
 IN MONUMENT BOX
 OVER STONE

