

# OTTAWA COUNTY ENGINEERS OFFICE

**REFERENCE NO.** 3-6-14-C  
 NE CORNER POST SEC. 3  
 HARRIS TWP.  
**SHEET** 1 OF 1.

**ROUTE:** STATE ROUTE #163  
 @ STATE ROUTE #590

**TOWNSHIP:** HARRIS


**SECTION:** 3

**T** 6 **NR** 14 **E.**

**NORTHING:**

**EASTING:**

**DATUM:**

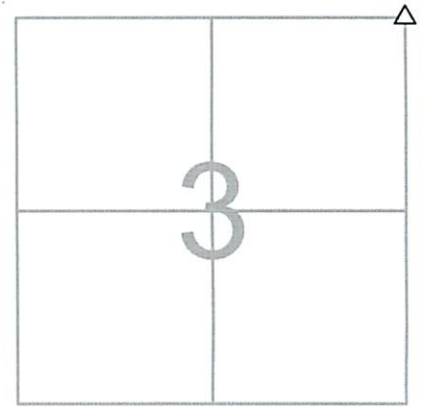

**PERSONNEL:**

M. WITTMAN, P.S.  
 J. ALLEN  
 S. CODER, P.S. - ODOT  
 J. RHODES - ODOT  
 SHELLY CO.

**DATE / WEATHER / TEMP:**

AUGUST 22, 2013  
 OVERCAST - W,SW  
 70° F

MONUMENT INFORMATION

MONUMENT TYPE: FD 5" X 6" LIMESTONE  
 ON SURFACE - BELOW: 2.09'  
 LEFT - CL PAVT - RIGHT:  
  
 POINTED STONE WITH SMALL DRILL HOLE IN PIPE  
 MARK ON POINTED SE CORNER - USED DRILL HOLE



MISC. INFORMATION

FD 3/4" Ø BY 19" LONG IRON PIPE 0.51' BELOW SURFACE.  
 IRON PIPE PER ODOT RECORDS. REMOVED IRON PIPE  
 AND DUG FOR STONE.  
  
 SET 1" Ø X 19" LONG IRON PIN IN FLOODED MASONRY  
 SAND IN 6" Ø PVC IN MONUMENT BOX OVER STONE WITH  
 ODOT AND SHELLY CO. ASSISTANCE

AUGUST 22, 2013

SET 1" Ø IRON PIN  
 IN MONUMENT BOX  
 OVER STONE

