

OTTAWA COUNTY ENGINEERS OFFICE

REFERENCE NO. 3-6-14-G
SW CORNER POST SECTION 3
HARRIS TWP.
SHEET 1 OF 1.

ROUTE: T-21 STANGE RD.

TOWNSHIP: HARRIS

SECTION: 3

T 6 NR 14 E.


PERSONNEL:
M. WITTMAN, P.S.
E. KOCH
C. MILLER

NORTHING:

EASTING:


DATE / WEATHER / TEMP:
JULY 1, 2009
CLOUDY W
68° F

DATUM:

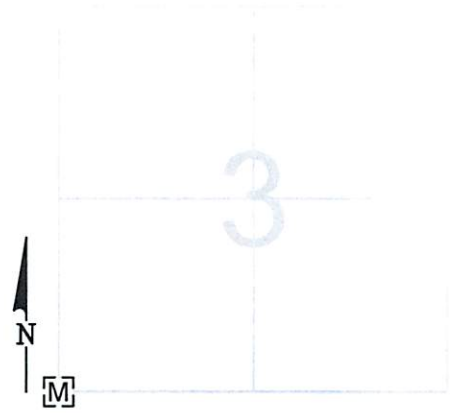

MONUMENT INFORMATION

MONUMENT TYPE: FD 1 1/4" SQ. IRON PIN IN
MONUMENT BOX
ON SURFACE - BELOW: 0.10'
LEFT - CL PAVT - RIGHT: 7.40'

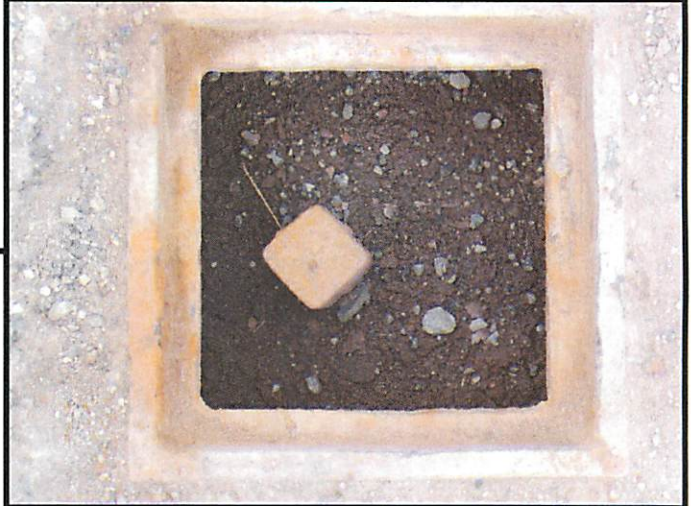

MISC. INFORMATION

MONUMENT BOX IS IN LINE WITH EAST EDGE OF
PAVEMENT.

