

OTTAWA COUNTY ENGINEERS OFFICE

REFERENCE NO. 4-6-14-B
 NORTH QUARTER POST SEC. 4
 HARRIS TWP.
SHEET 1 OF 1.

ROUTE: STATE ROUTE #163
 @ T-61 DEWITT RD.

TOWNSHIP: HARRIS


SECTION: 4

T 6 **NR** 14 **E.**

NORTHING:

EASTING:

DATUM:

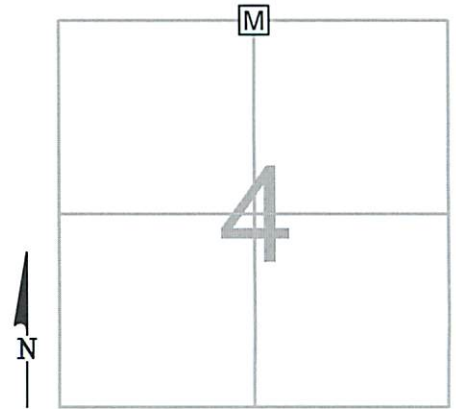

PERSONNEL:

M. WITTMAN, P.S.
 J. ALLEN
 C. MILLER
 D. HOHMAN, P.S. - ODOT
 T. ROUSOS - ODOT


DATE / WEATHER / TEMP:

MAY 2, 2013
 SUNNY - S, SW
 75° F

MONUMENT INFORMATION

MONUMENT TYPE: SET 1" Ø IRON PIN IN MON BOX
ON SURFACE - BELOW:
 LEFT - CL PAV'T - RIGHT: 2.0'

8-22-13:
 SET 1" Ø X 36" LONG IRON PIN IN FLOODED MASONRY
 SAND IN 6" Ø PVC IN MONUMENT BOX WITH ODOT AND
 SHELLY CO.

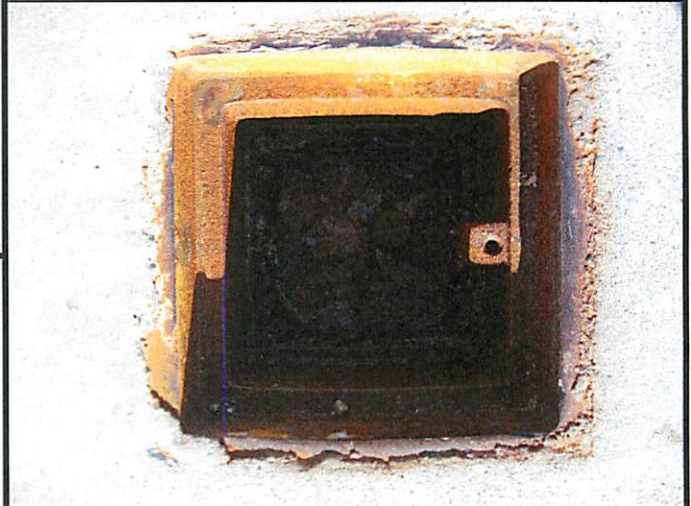

MISC. INFORMATION

FD PK NAIL AND SHINER ON SURFACE, TIED W/ X-TIES AND DUG
 FOR STONE. FD PK NAIL AND SHINER 0.19' BELOW SURFACE, NAIL
 AND SHINER WAS DIRECTLY BELOW SURFACE NAIL. FD MINE
 SPIKE AND WASHER 0.39' BELOW SURFACE 0.01' N AND 0.02' W OF
 SURFACE NAIL. INADVERTENTLY REMOVED A RAILROAD SPIKE
 BEFORE LOCATION COULD BE DETERMINED. NO STONE OR
 OTHER TYPE OF MONUMENTATION FOUND. USED SINGLE
 PROPORTIONATE MEASURE BASED ON 1898 DEWITT SURVEY
 (SB 3 PG 229) TO ESTABLISH LOCATION ON 5-3-13.

AUGUST 22, 2013

SET 1" Ø IRON PIN IN
 MONUMENT BOX

