

OTTAWA COUNTY ENGINEERS OFFICE

REFERENCE NO. 4-6-14-D
WEST QUARTER POST SEC. 4
HARRIS TWP.
SHEET 1 OF 1.

ROUTE: T-19 GRAYTOWN RD.
@ T-60 KEMPKE RD.

TOWNSHIP: HARRIS

SECTION: 4

T 6 NR 14 E.


NORTHING:

EASTING:

DATUM:

PERSONNEL:
M. WITTMAN, P.S.
J. ALLEN
M. ULLRICH
S. ULLRICH

DATE / WEATHER / TEMP:
JULY 10, 2008
SUNNY S
74° F

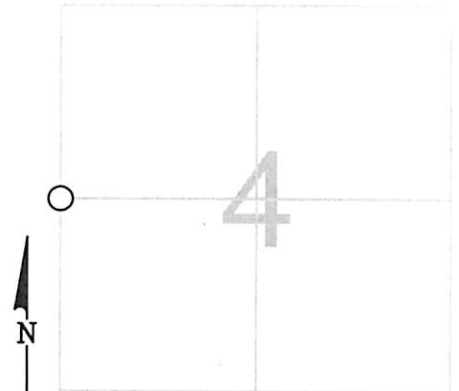

MONUMENT INFORMATION

MONUMENT TYPE: FD. 1" SQUARE IRON PIN W/
DRILL HOLE IN 6" Ø CLAY TILE
ON SURFACE - BELOW: 0.48'
LEFT - CL PAV'T - RIGHT: 2.0'



MISC. INFORMATION

IRON PIN SET IN 1960 PER COUNTY STONE
RECORD BOOK

JULY 10, 2008

PLACED MONUMENT BOX
OVER PIN

