

# OTTAWA COUNTY ENGINEERS OFFICE


REFERENCE NO. 4-6-14-I  
SE CORNER POST SECTION 4  
HARRIS TWP.  
SHEET 1 OF 1.

ROUTE: T-21 STANGE RD.  
TOWNSHIP: HARRIS  
SECTION: 4  
T 6 NR 14 E.

PERSONNEL:  
M. WITTMAN, P.S.  
E. KOCH  
C. MILLER


NORTHING:  
EASTING:  
DATUM:

DATE / WEATHER / TEMP:  
JULY 1, 2009  
CLOUDY W  
68° F

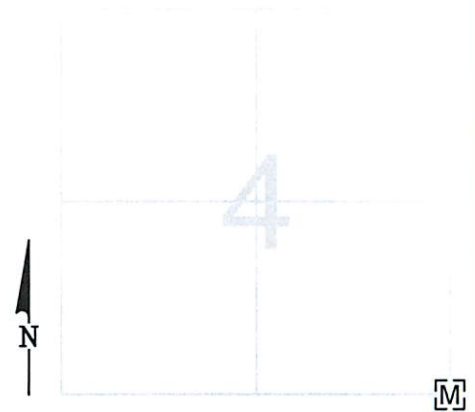

## MONUMENT INFORMATION

MONUMENT TYPE: FD 1 1/4" SQ. IRON PIN IN  
MONUMENT BOX  
ON SURFACE - BELOW: 0.10'  
LEFT - CL PAV'T - RIGHT: 7.40'

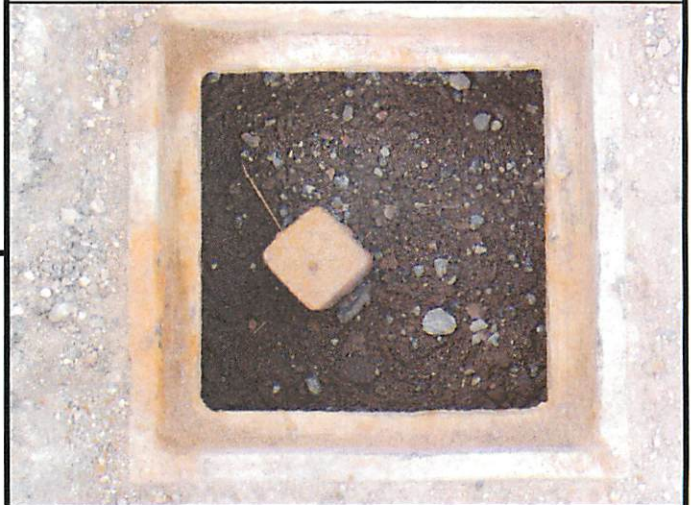

## MISC. INFORMATION

MONUMENT BOX IS IN LINE WITH EAST EDGE OF  
PAVEMENT.

