

# OTTAWA COUNTY ENGINEERS OFFICE

REFERENCE NO. 5-6-14-A  
NW CORNER POST SECTION 5  
HARRIS TWP.  
SHEET 1 OF 1.

PERSONNEL:  
M. WITTMAN, P.S.  
J.D. BARNES

DATE / WEATHER / TEMP:  
APRIL 22, 2007  
SUNNY S  
80° F

ROUTE: C-208 ELLISTON-TROWBRIDGE RD.  
@ S-163 STATE ROUTE 163

TOWNSHIP: HARRIS


SECTION: 5

T 6 NR 14 E.

NORTHING:

EASTING:

DATUM:

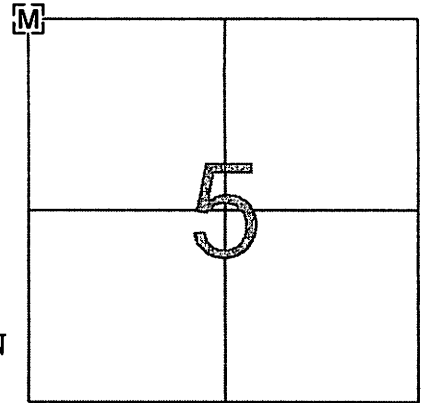

## MONUMENT INFORMATION

MONUMENT TYPE: FD 1-1/4" IRON PIN IN MON BOX  
ON SURFACE - BELOW:  
LEFT - CL PAVT - RIGHT:

## MISC. INFORMATION

5-29-1986: R. STEINMILLER, P.S., J. UNDERWOOD,  
T. THORBAHN AND J. CRONIN FROM ODOT - FD  
8-1/2" x 5-1/2" x 6" STONE 18-1/2" BELOW SURFACE  
- SET IRON PIN IN MONUMENT BOX

POINT FOR C/L CONSTRUCTION OF S.R. #163 IS  
APPROX. 1' S. OF NE COR POST

PHOTO OF STONE NOT AVAILABLE

## NEW TIES: 4-22-2007

M. WITTMAN, P.S.  
J.D. BARNES

