


OTTAWA COUNTY ENGINEERS OFFICE

REFERENCE NO. 6-6-14-B
 N QUARTER POST SECTION 6
 HARRIS TWP.
SHEET 1 OF 1.

ROUTE: S-163 STATE ROUTE #163
TOWNSHIP: HARRIS
SECTION: 6
T 6 **NR** 14 **E.**

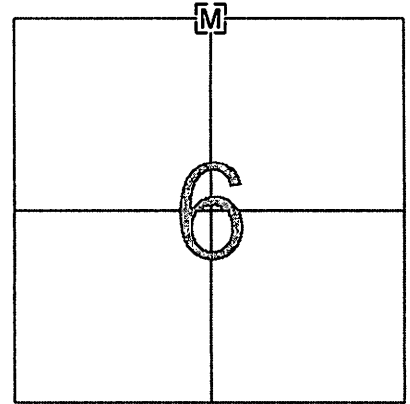

PERSONNEL:
 R. STEINMILLER, P.S.
 J. UNDERWOOD
 T. THORBAHN
 J. CRONON - ODOT

NORTHING:
EASTING:
DATUM:

DATE / WEATHER / TEMP:
 JUNE 11, 1986
 CLDY - SW
 75° F (HUMID)

MONUMENT INFORMATION


MONUMENT TYPE: FD 1-1/4" IRON PIN IN MON BOX
ON SURFACE - BELOW:
LEFT - CL PAV'T - RIGHT: 3' +/-

PHOTO OF STONE NOT AVAILABLE

MISC. INFORMATION

6-11-1986: R. STEINMILLER, P.S., J. UNDERWOOD, T. THORBAHN AND J. CRONIN FROM ODOT - FD BOAT SPIKE 1-1/2" BELOW SURFACE. SET SHORT PK TIES 2.00' NORTH AND 2.00' WEST. FD 5-1/2" x 6" x 10" SQUARE TOP LIMESTONE 1.38' BELOW THE SURFACE - SET IRON PIN IN MONUMENT BOX

THERE IS ANOTHER IRON PIN IN A MONUMENT BOX 3' +/- SOUTH OF POINT THAT MARKS THE C/L OC CONSTRUCTION OF SR #163.

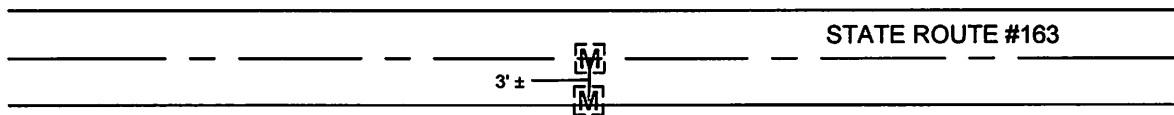

USING SHORT TIES
 PK N - 2.28'
 PK W - 2.405'

PI C/L CONSTRUCTION
 IRON PIN IN MON BOX
 SOUTH OF N 1/4 POST