

OTTAWA COUNTY ENGINEERS OFFICE

REFERENCE NO. 6-6-14-C
NE CORNER POST SECTION 6
HARRIS TWP.
SHEET 1 OF 1.

PERSONNEL:
M. WITTMAN, P.S.
J.D. BARNES

DATE / WEATHER / TEMP:
APRIL 22, 2007
SUNNY S
80° F

ROUTE: C-208 ELLISTON-TROWBRIDGE RD.
@ S-163 STATE ROUTE 163

TOWNSHIP: HARRIS


SECTION: 6

T 6 N R 14 E.

NORTHING:

EASTING:

DATUM:

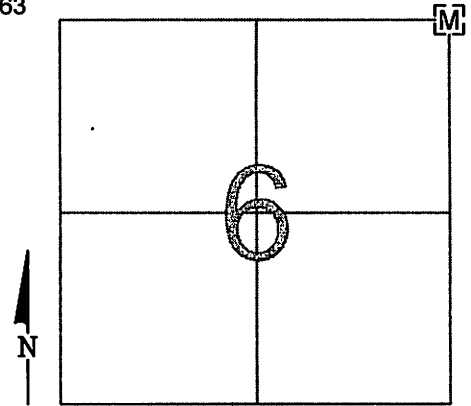

MONUMENT INFORMATION

MONUMENT TYPE: FD 1-1/4" IRON PIN IN MON BOX
ON SURFACE - BELOW:
LEFT - CL PAVT - RIGHT:

MISC. INFORMATION

5-29-1986: R. STEINMILLER, P.S., J. UNDERWOOD,
T. THORBAHN AND J. CRONIN FROM ODOT - FD
8-1/2" x 5-1/2" x 6" STONE 18-1/2" BELOW SURFACE
- SET IRON PIN IN MONUMENT BOX

POINT FOR C/L CONSTRUCTION OF S.R. #163 IS
APPROX. 1' S. OF NE COR POST

PHOTO OF STONE NOT AVAILABLE

NEW TIES: 4-22-2007

M. WITTMAN, P.S.
J.D. BARNES

