

OTTAWA COUNTY ENGINEERS OFFICE

REFERENCE NO. 6-6-14-F
EAST QUARTER POST SEC 6
HARRIS TWP.
SHEET 1 OF 1.

PERSONNEL:
M. WITTMAN, P.S.
J. ALLEN
J. LAUBACHER

DATE / WEATHER / TEMP:
AUGUST 4, 2011
OVERCAST NE
79° F

ROUTE: C-208 ELLISTON TROWBRIDGE
@ T-60 KEMPKE

TOWNSHIP: HARRIS


SECTION: 6

T 6 N R 14 E.

NORTHING:

EASTING:

DATUM:

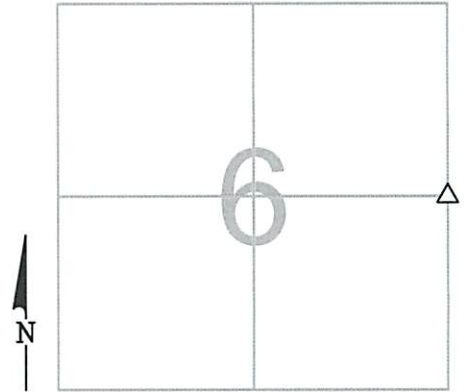

MONUMENT INFORMATION

MONUMENT TYPE: FD 6" X 8" HARD HEAD STONE
ON SURFACE - BELOW: 2.22'
LEFT - CL PAV'T - RIGHT: 5.90'



MISC. INFORMATION

JULY 19, 2011

SET 1" SQUARE IRON PIN
IN MONUMENT BOX OVER
STONE

