

# OTTAWA COUNTY ENGINEERS OFFICE

REFERENCE NO. 7-6-14-C  
NE CORNER POST SECTION 7  
HARRIS TWP.  
SHEET 1 OF 1.

ROUTE: C-208 ELLISTON TROWBRIDGE RD  
@ T-57 DENO RD

TOWNSHIP: HARRIS


SECTION: 7

T 6 NR 14 E.

NORTHING:

EASTING:

DATUM:

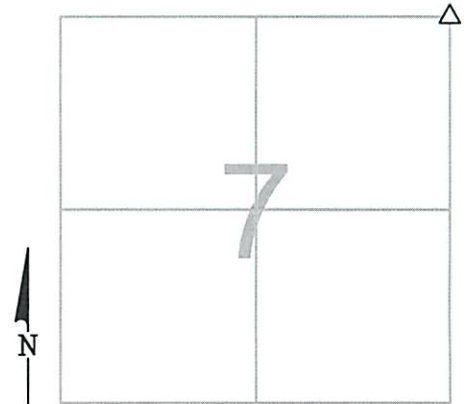

PERSONNEL:  
M. WITTMAN, P.S.  
J. ALLEN  
J. LAUBACHER

DATE / WEATHER / TEMP:  
JULY 19, 2011  
PARTLY SUNNY NW  
88° F

## MONUMENT INFORMATION

MONUMENT TYPE: FD 6"X 12" HARDHEAD STONE  
ON SURFACE - BELOW: 1.56'  
LEFT - CL PAV'T - RIGHT: 1.80'



## MISC. INFORMATION

FD PK NAIL 0.21' BELOW SURFACE  
TIED W/ X-TIES, DUG FOR STONE  
USED HIGH POINT OF STONE  
FD PK NAIL WAS 0.02' S AND 0.03' E

JULY 19, 2011

SET 1" SQUARE IRON PIN  
IN MONUMENT BOX OVER  
STONE

